




1550 Sawgrass Corporate Parkway

Second floor
21,431 r.s.f.

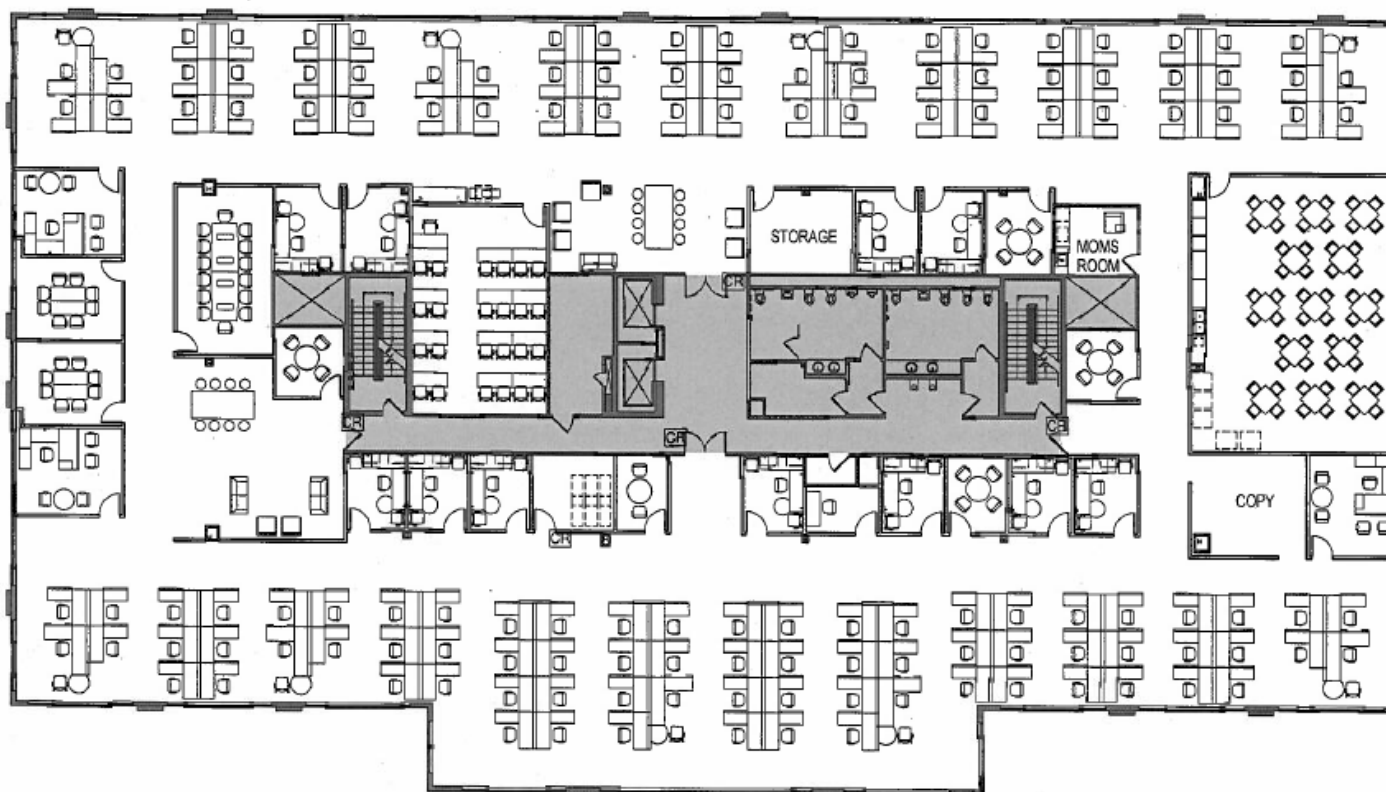

Sandra Andersen
Senior Vice President
+1 954 760 4854
sandra.andersen@am.jll.com
Lic. Real Estate Brokers

Elizabeth Jimenez
Associate
+1 954 233 3441
elizabeth.jimenez@am.jll.com

