


Sawgrass Centre

1560 Sawgrass Centre

Suite 240 | 2,562



SAWGRASS
CENTRE

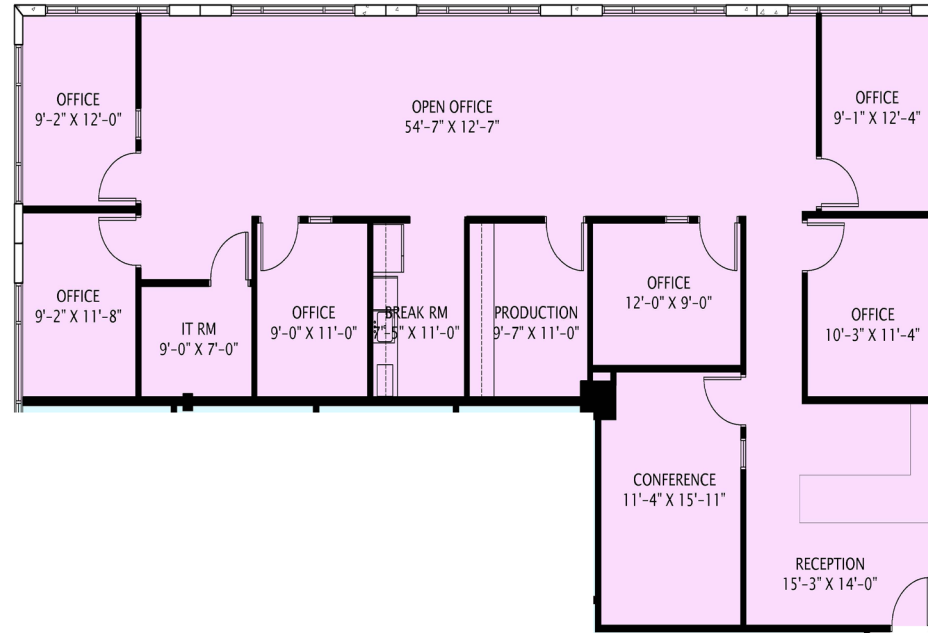

WWW.SAWGRASSCENTRE.COM

Sandra Andersen,
Senior Vice President

+1 954 760 4854
sandra.andersen@am.jll.com

Elizabeth Jimenez,
Brokerage Associate

+1 954 233 3441
elizabeth.jimenez@am.jll.com

